
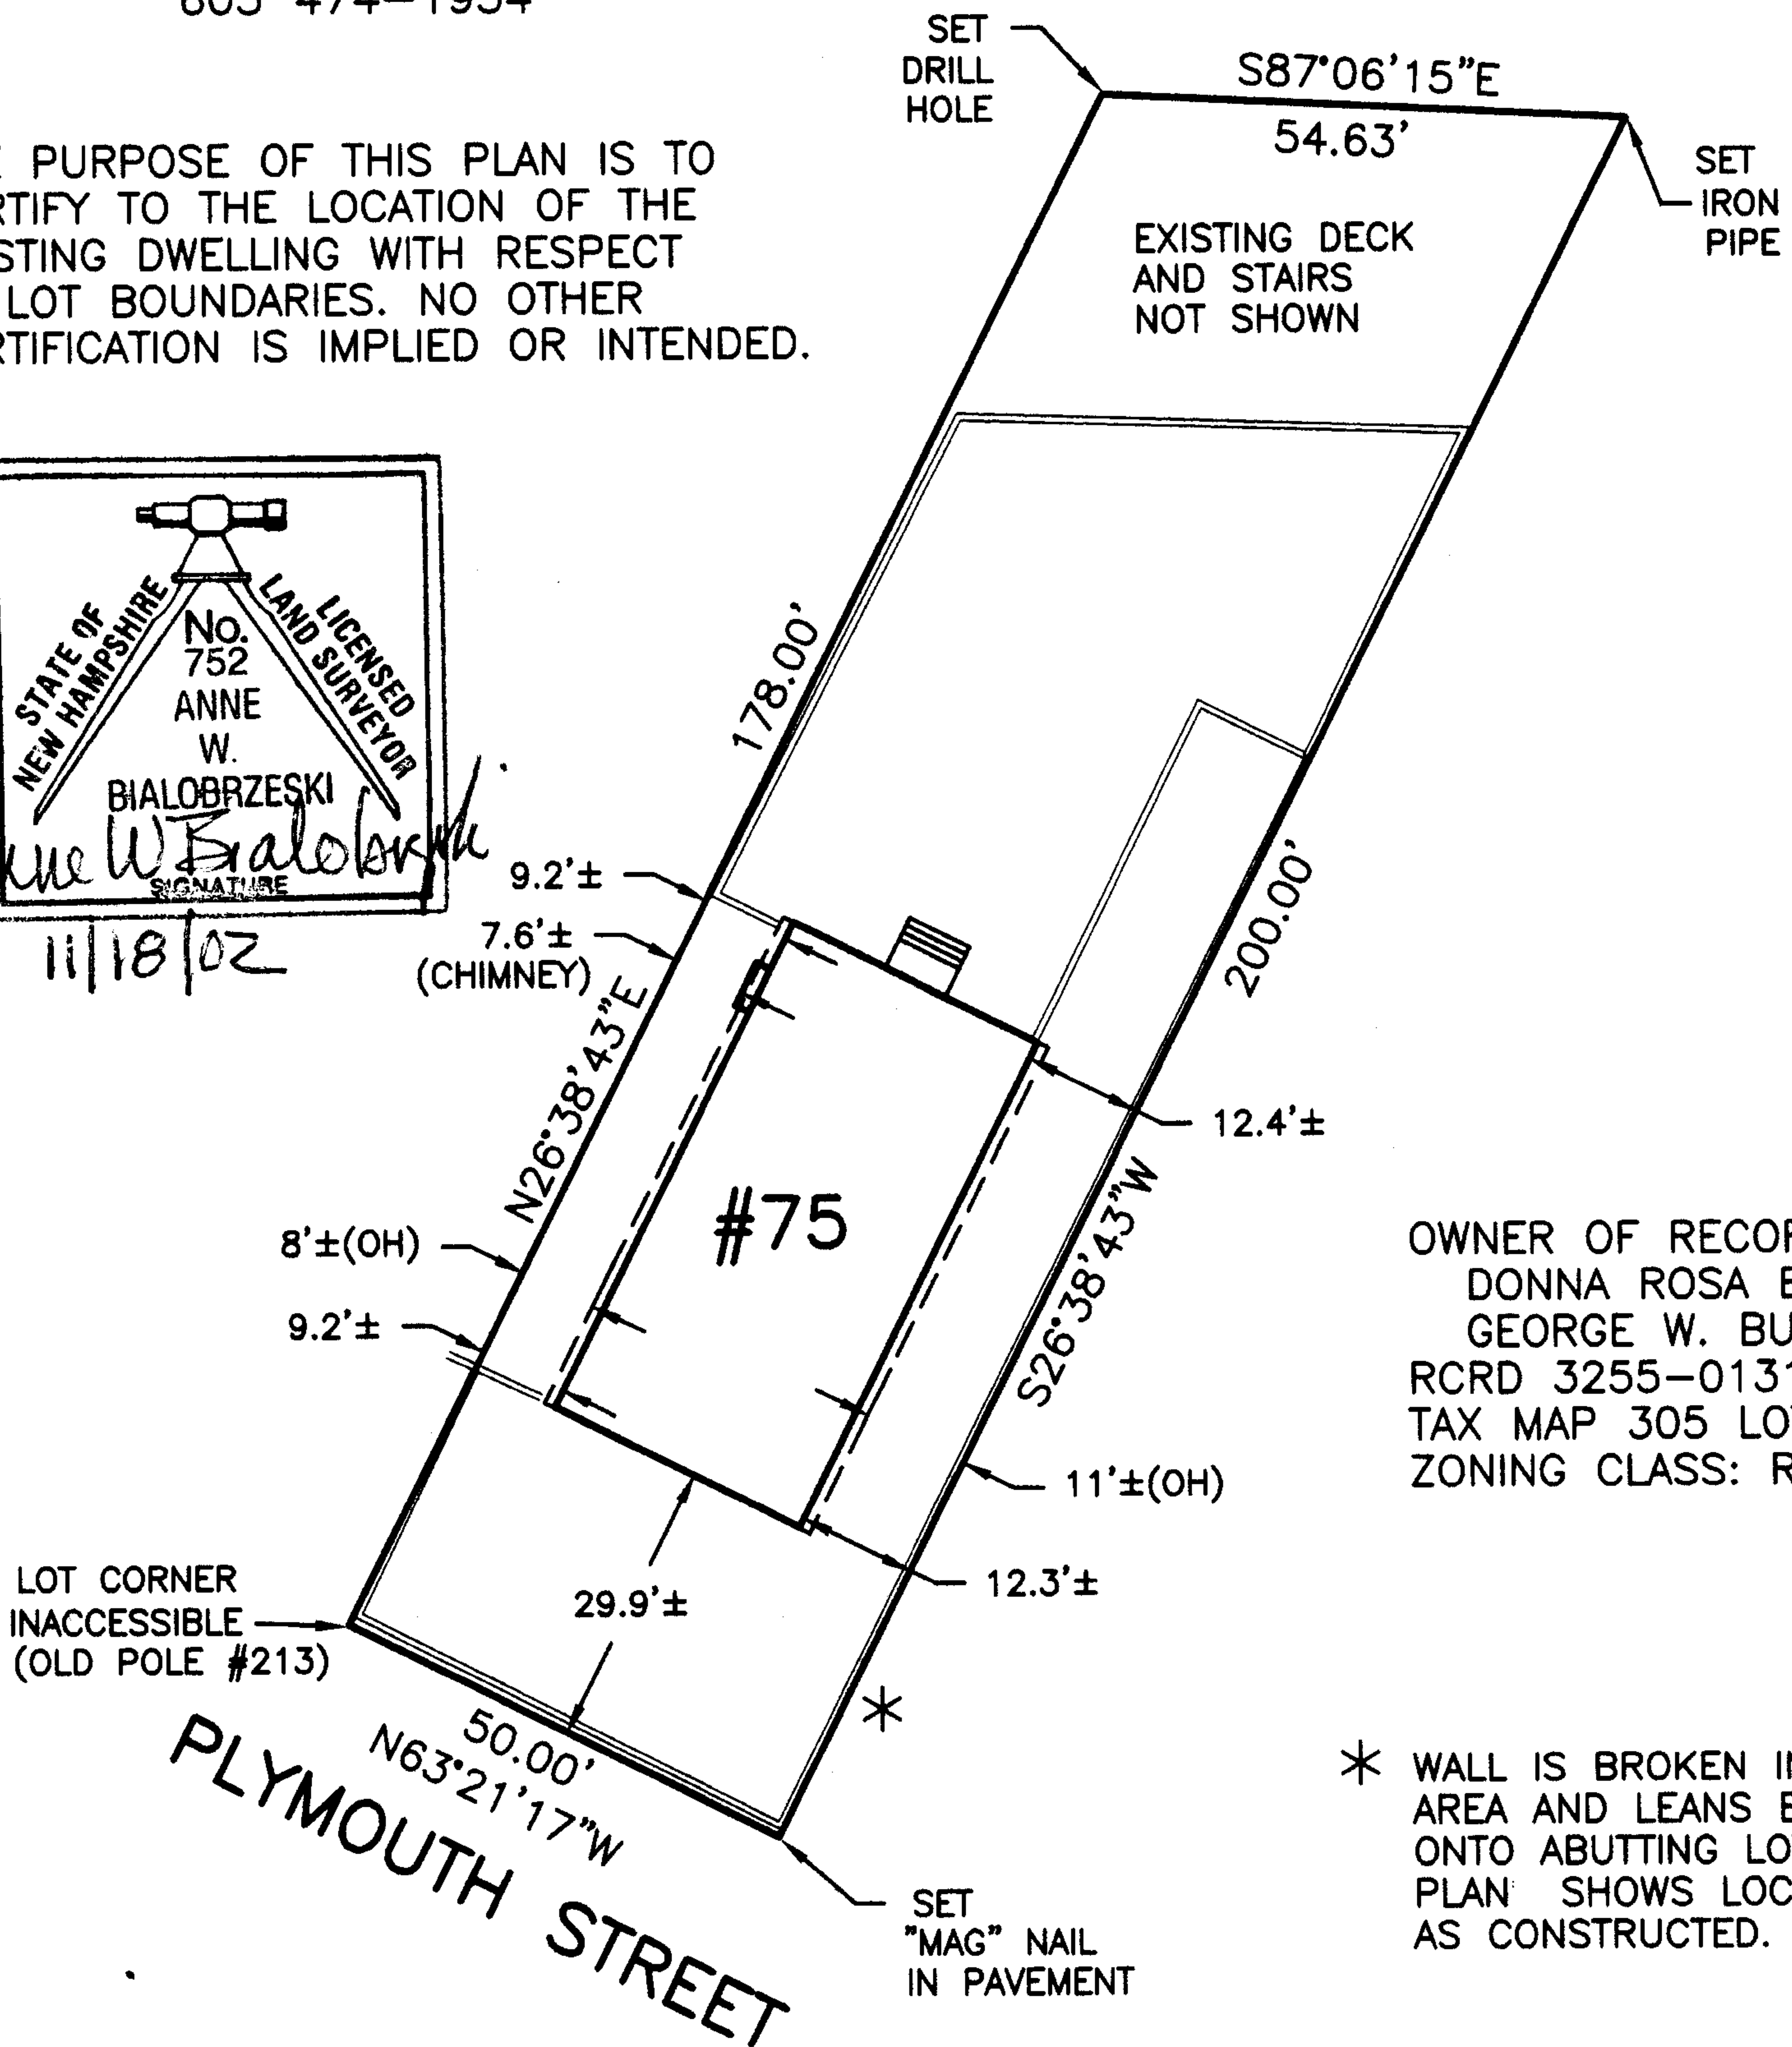


LOCATION PLAN
75 PLYMOUTH STREET
HAMPTON, NH
SCALE: 1"=30' NOV 18, 2002

PREPARED BY
STOCKTON SERVICES
PO BOX 1306 HAMPTON, NH
603 474-1954

THE PURPOSE OF THIS PLAN IS TO
CERTIFY TO THE LOCATION OF THE
EXISTING DWELLING WITH RESPECT
TO LOT BOUNDARIES. NO OTHER
CERTIFICATION IS IMPLIED OR INTENDED.

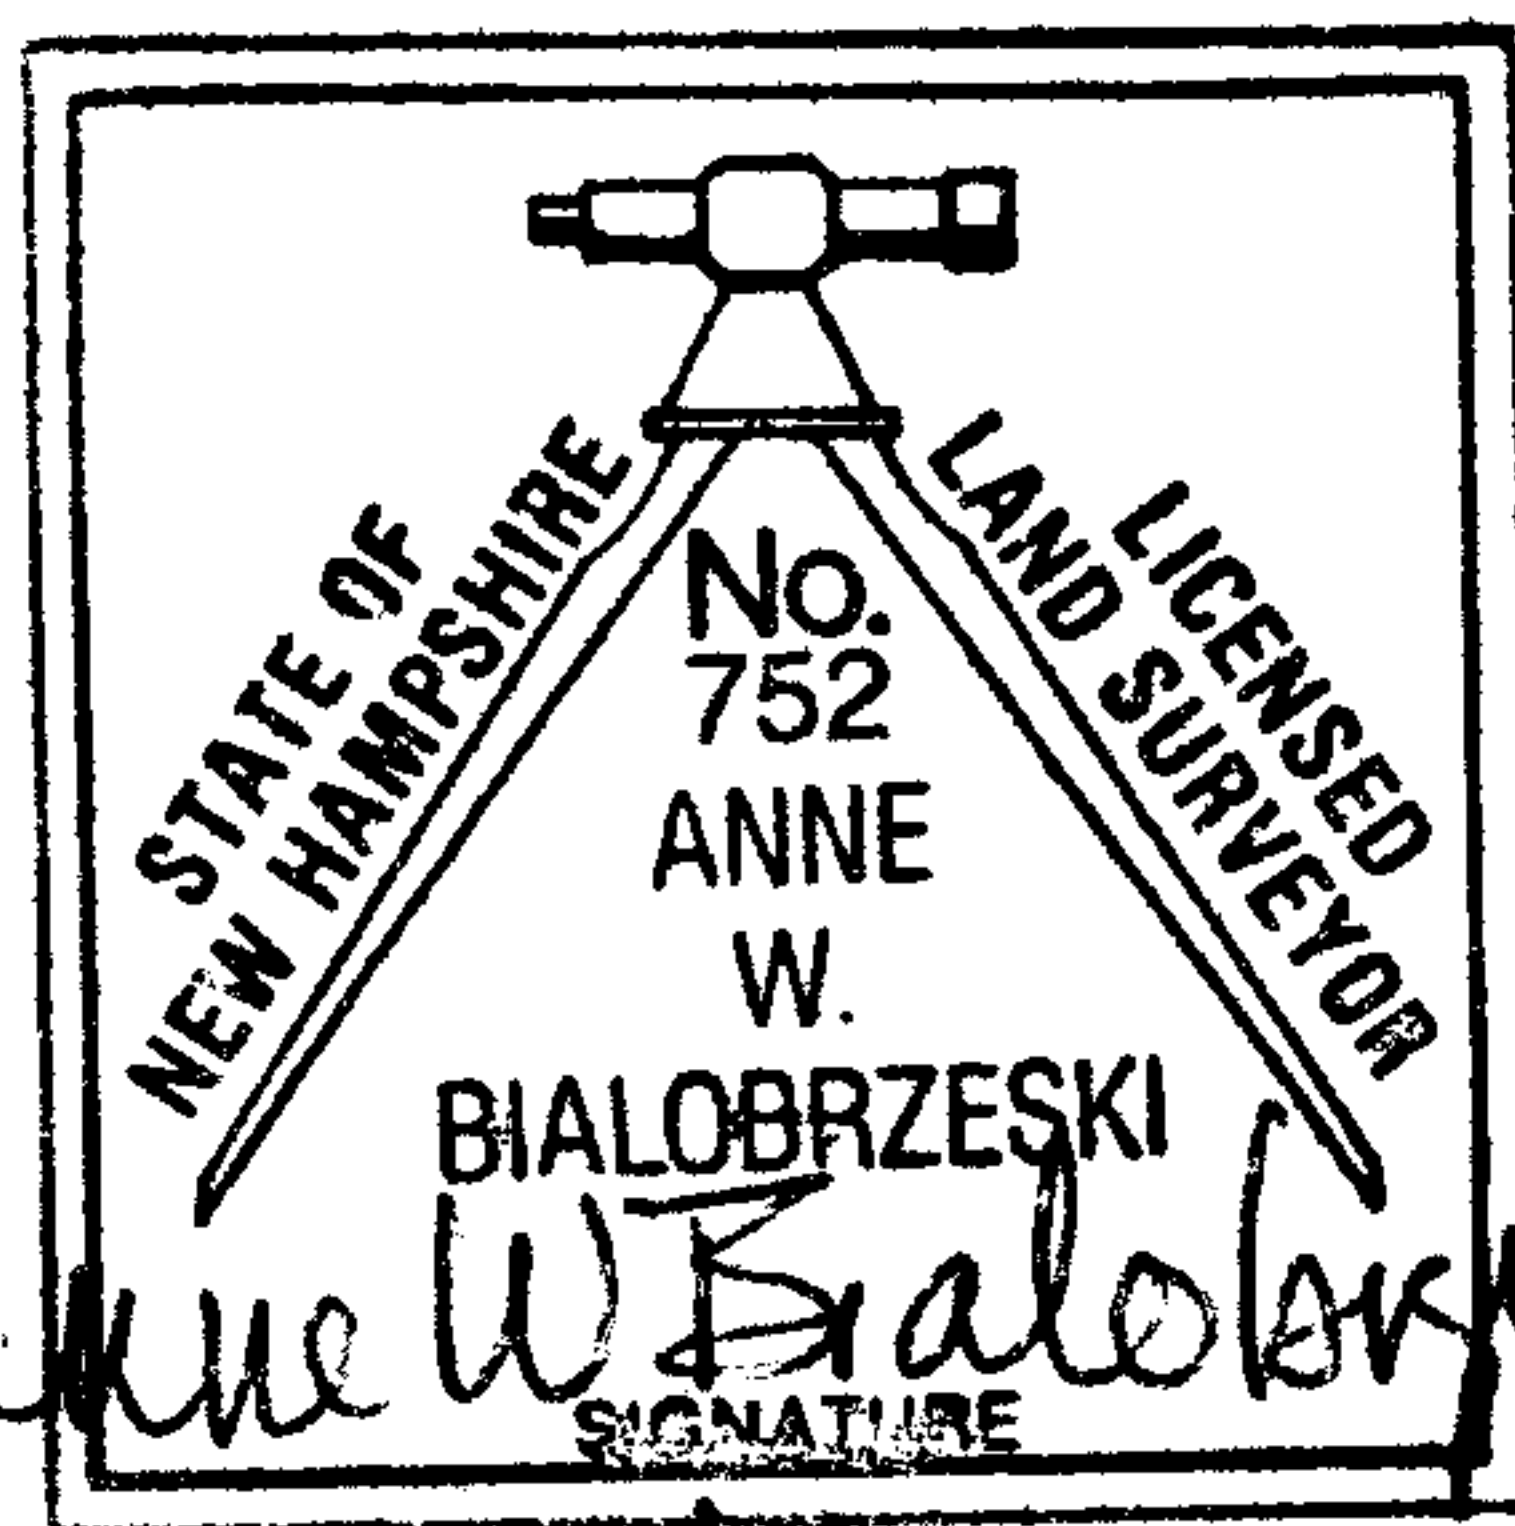

OWNER OF RECORD:
DONNA ROSA BURKE &
GEORGE W. BURKE III
RCRD 3255-0131
TAX MAP 305 LOT 8
ZONING CLASS: RA

* WALL IS BROKEN IN THIS
AREA AND LEANS EASTERLY
ONTO ABUTTING LOT.
PLAN SHOWS LOCATION
AS CONSTRUCTED.